

P.O. Box 665 – 117 West Main Street
Hahira, GA 31632

Phone: 229-585-9018

E-mail:
mail@altmanbarrettarchitects.com



Letter of Transmittal

TO: Plan Holders

FROM: Travis Petitjean

DATE: 10/4/21

SUBJECT: Addendum 1
Stadium and Field Improvements
West Laurens High School
Laurens County School District

WE ARE SENDING YOU:

- ☐ Enclosed
- ☐ Prints
- ☐ Change order

5 Pages via EMAIL (including cover)
☐ Specifications

ENCLOSED:

<u>COPIES</u>	<u>DATE</u>	<u>DESCRIPTION</u>
1	10/4/21	Addendum 1


Transmitted as checked below:

- | | |
|--|--|
| <input checked="" type="checkbox"/> For your use | <input type="checkbox"/> No exceptions taken |
| <input type="checkbox"/> As requested | <input type="checkbox"/> Exceptions noted |
| <input type="checkbox"/> For your information | <input type="checkbox"/> Resubmit |
| <input type="checkbox"/> For review & comment | |

REMARKS:

COPY: A+B File 21013 / A-1

[M:\21013 Laurens - West Laurens High Stadium Renovations\Addenda\Transmittal Add 1.doc]

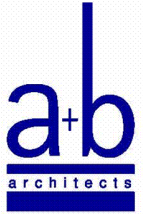

**WEST LAURENS HIGH SCHOOL STADIUM RENOVATIONS
3692 HIGHWAY 257, DEXTER, GA 31019
LAURENS COUNTY SCHOOL DISTRICT**

ADDENDUM NO. 1

October 4, 2021

REVISIONS TO THE SPECIFICATIONS:

1. Section 004322 Unit Prices Form:
 - a. Part 3.01 / A:
 - i. Strike through the phrase "per unit" when submitting this form. This corresponds with Section 012200.
 - b. Part 3.02 / A:
 - i. Strike through the phrase "per unit" when submitting this form. This corresponds with Section 012200.
 - c. Part 3.03 / A:
 - i. Strike through the phrase "per unit" when submitting this form. This corresponds with Section 012200.
2. Section 047200 Cast Stone Masonry:
 - a. Part 20.02 / A:
 - i. Add the following; "5. Bassco Caststone (Elkmont, AL)" as an approved manufacturer.

REVISIONS TO THE DRAWINGS:


1. Sheet C1.1:
 - a. Delete in its entirety and replace with the attached Sheet C1.1 which modifies the demolition of sidewalk along the plan right of the field where clouded.
 - b. Add the following note: "REMOVE FENCE" along plan left of the playing field. Refer to Sheet A2000 for corresponding note.
 - c. Add the following note; "REMOVE FENCE" at plan bottom left of the site plan. Refer to Sheet A2000 for corresponding note and new fence information.
2. Sheet C2.1:
 - a. Delete in its entirety and replace with the attached Sheet C2.1 which modifies the extent of turf on plan right of the field where clouded.
 - b. Add the following note; "NEW FENCE" along plan left of the grandstands near the main entrance gates. Refer to Sheet A2000 for corresponding note and fence type.
3. Sheet C4.1:
 - a. Add the following note; "INSTALLATION OF THE EROSION CONTROL MEASURES ARE THE RESPONSIBILITY OF THE GENERAL CONTRACTOR FOR THIS PROJECT

AND NOT THE ARTIFICIAL TURF MANUFACTURER / INSTALLER.”

END

PLAN: STADIUM + FIELD IMPROVEMENTS (2) West Laurens High School, Macon, GA 31210, 10/20/2021 8:41:03 AM
DRAWN: M. Roberts, A. Harris
CHECKED: D. Carter
REVISIONS: 1 10/4/2021
www.altmanbarrettarchitects.com

A l t m a n + B a r r e t t A r c h i t e c t s

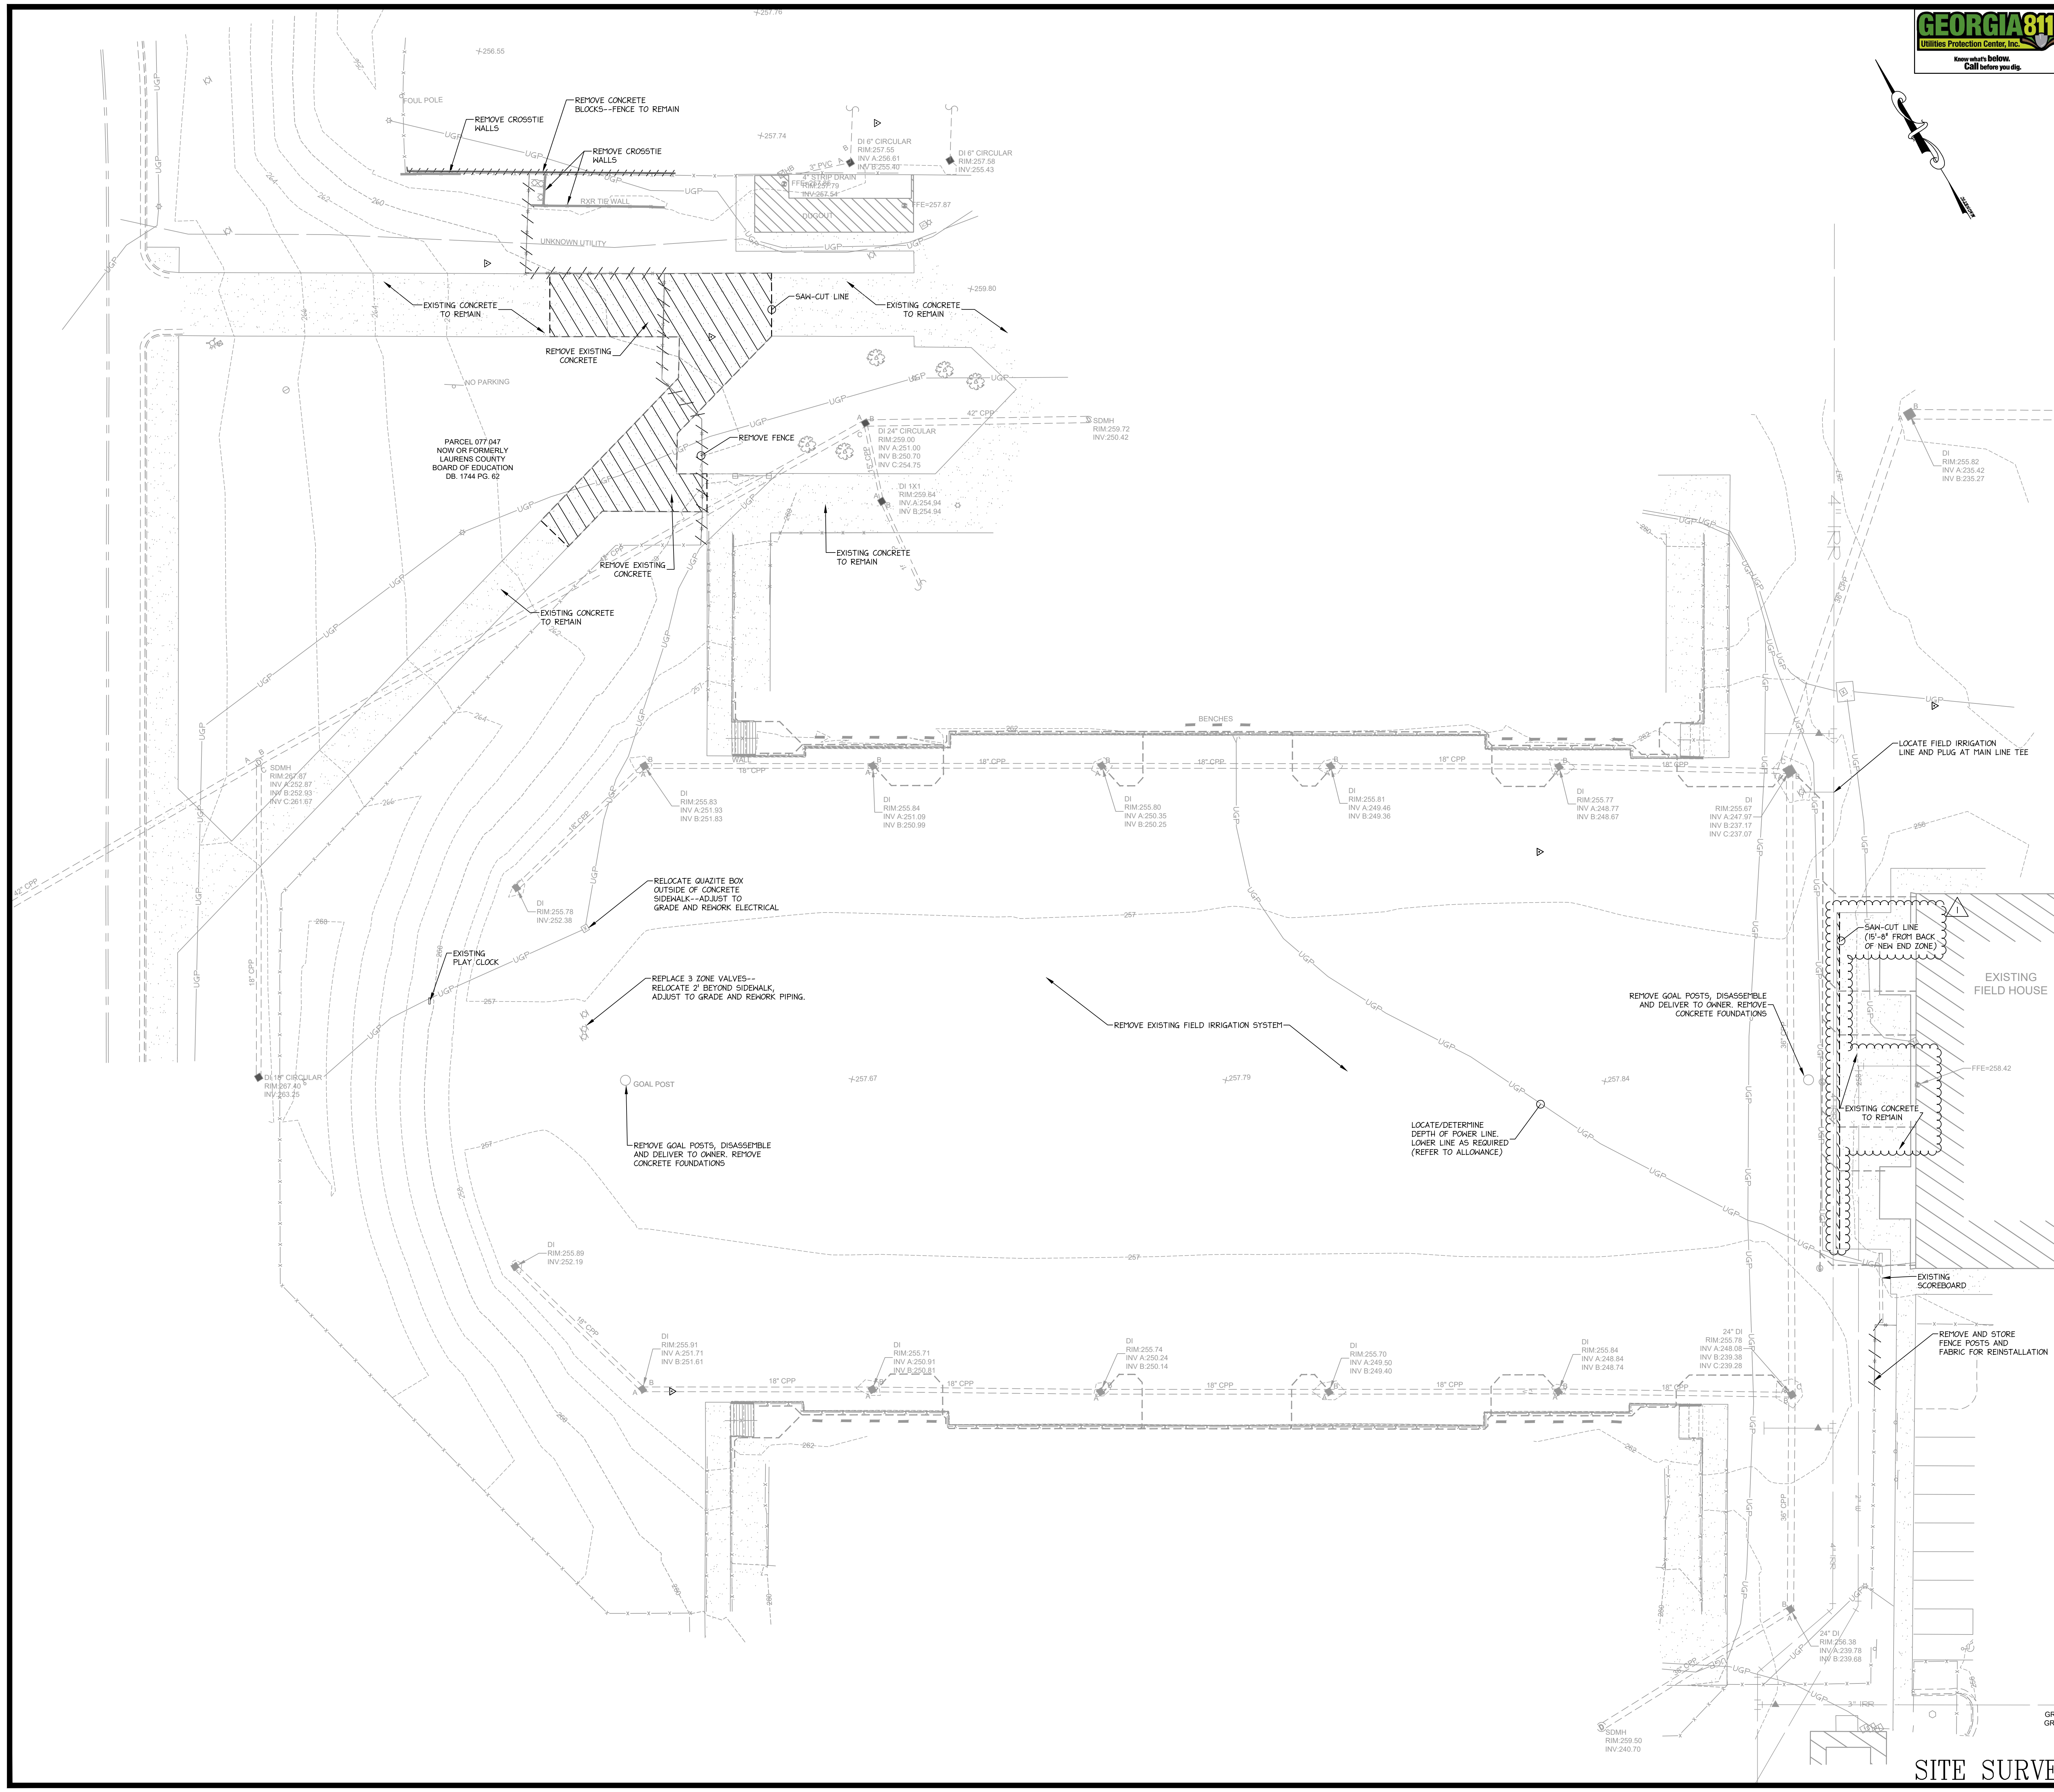


- DEMOLITION NOTES:**
1. CONTRACTOR SHALL CONFIRM LOCATION AND DEPTHS OF ALL UNDERGROUND UTILITIES PRIOR TO ANY DEMOLITION OR CONSTRUCTION. CONTRACTOR SHALL USE A PRIVATE UTILITY LOCATOR SERVICE FOR PRIVATELY OWNED UTILITY LINES NOT MARKED BY UTILITIES PROTECTION SERVICE/INC. CONTRACTOR SHALL BE RESPONSIBLE FOR PAYING LOCATOR SERVICE. UTILITY LOCATIONS SHOWN ON THE DRAWINGS ARE BASED UPON FIELD OBSERVATIONS AND RECORD DRAWINGS. THESE LOCATIONS ARE APPROXIMATE AND MAY BE INCOMPLETE. THE UTILITIES PROTECTION CENTER MUST BE CONTACTED AT 811 THREE BUSINESS DAYS PRIOR TO BEGINNING CONSTRUCTION.
 2. ALL PAVED SURFACES, CURBS, SIDEWALKS, AND ALL OTHER MATERIALS NOTED TO BE DEMOLISHED/REMOVED SHALL BE DISCARDED OFFSITE IN A LEGAL AND LAWFUL MANNER. (REFER TO SPECIFICATIONS FOR ADDITIONAL REQUIREMENTS.)
 3. EXISTING OPERATIONAL UTILITY METERS, VALVES, BOXES, POLES, ETC. SHALL REMAIN, OR SHALL BE RELOCATED AS NECESSARY TO PROVIDE REQUIRED SERVICE. COORDINATE RELOCATION OF SERVICES, MAINS, ETC. WITH RESPECTIVE UTILITY OWNER.
 4. STORM DRAIN STRUCTURES AND ALL OTHER UTILITIES NOT TO BE DISCONNECTED SHALL REMAIN OPERATIONAL AND IN SERVICE DURING CONSTRUCTION. WHERE STORM PIPES ARE REMOVED AND STRUCTURES REMAIN, PLUG OPENINGS WITH 8-INCH THICK CONCRETE (3000psi).
 5. CONTRACTOR SHALL NOTIFY OWNER'S REPRESENTATIVE IF UNMARKED OR UNCHARTED UTILITIES ARE ENCOUNTERED.
 6. CONTRACTOR SHALL COORDINATE IRRIGATION LINE REMOVAL WITH OWNER. CONTRACTOR SHALL TERMINATE LINE WITH FITTING AT MAIN LINE TEE.
 7. CONTRACTOR SHALL BE RESPONSIBLE FOR INSTALLING PROTECTION FOR CONSTRUCTION ACCESS. CONTRACTOR SHALL BE RESPONSIBLE FOR REPAIRING DAMAGED AREAS.



SITE SURVEY AND DEMOLITION PLAN



Altman + Barrett

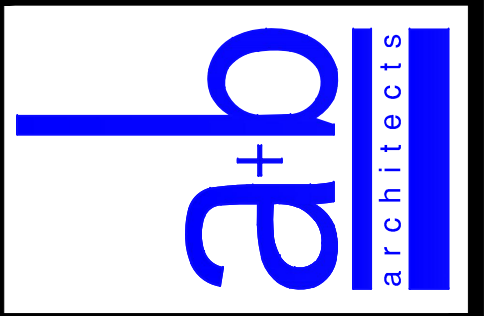

Altman + Barrett
a r c h i t e c t s
P.O. BOX 665 - 117 WEST MAIN ST.
HAHIRA, GEORGIA 31632
PHONE # (229) 585-9018

DATE: August 30, 2021
DRAWN: M. Roberts, A. Harris
CHECKED: D. Carter
REVISIONS: 1 10/4/2021
www.altmanbarrettarchitects.com

Stadium and Field Improvements
West Laurens High School
3692 Highway 257 Dexter, GA 31019
Laurens County School District

C1.1


Drawings are the property of the architect and shall not be reproduced or used without written permission and credit.
© 2021 Altman + Barrett Architects, P.C.

PROJECT NO: 21013

A3875.012 Master.dwg

P:\A375\121021\A375-012 Master.dwg 11/22/2021 9:41:11 AM

A l t m a n + B a r r e t t A r c h i t e c t s

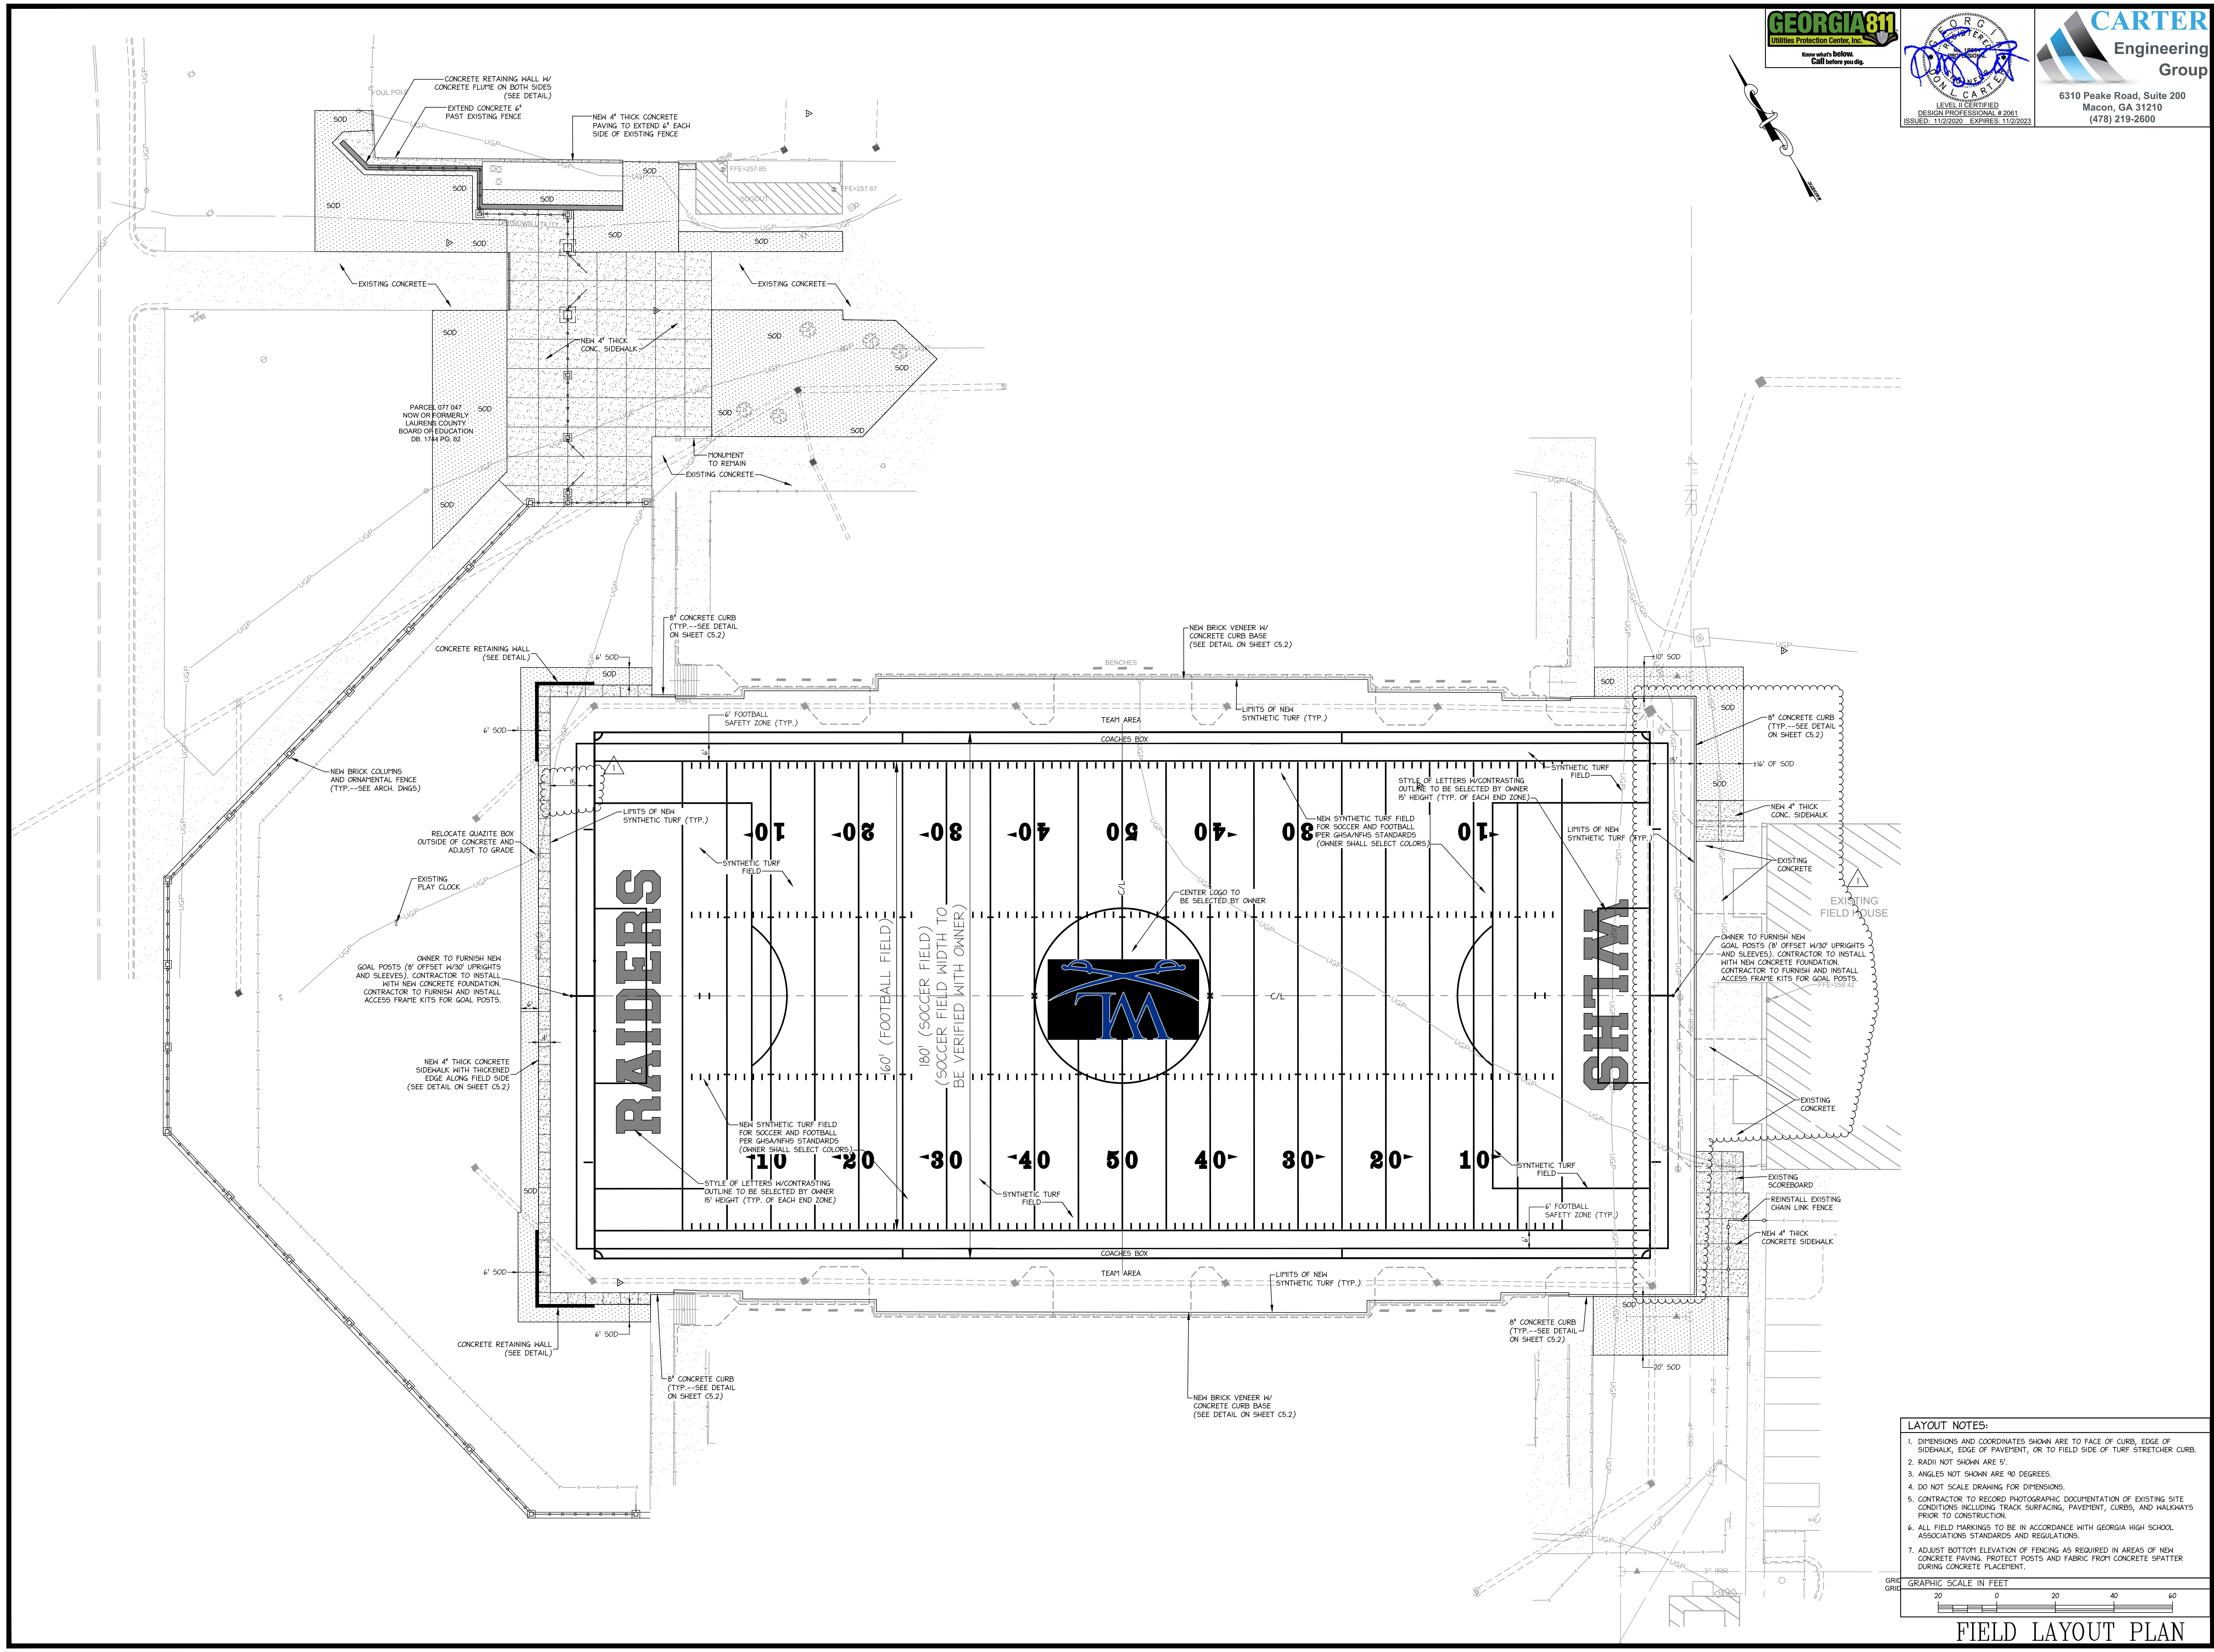




Georgia 811
Know what's below.
Call before you dig.



LEVEL II CERTIFIED
DESIGN PROFESSIONAL # 2061
ISSUED: 11/2/2020 EXPIRES: 11/2/2023



CARTER
Engineering
Group
6310 Peake Road, Suite 200
Macon, GA 31210
(478) 219-2600

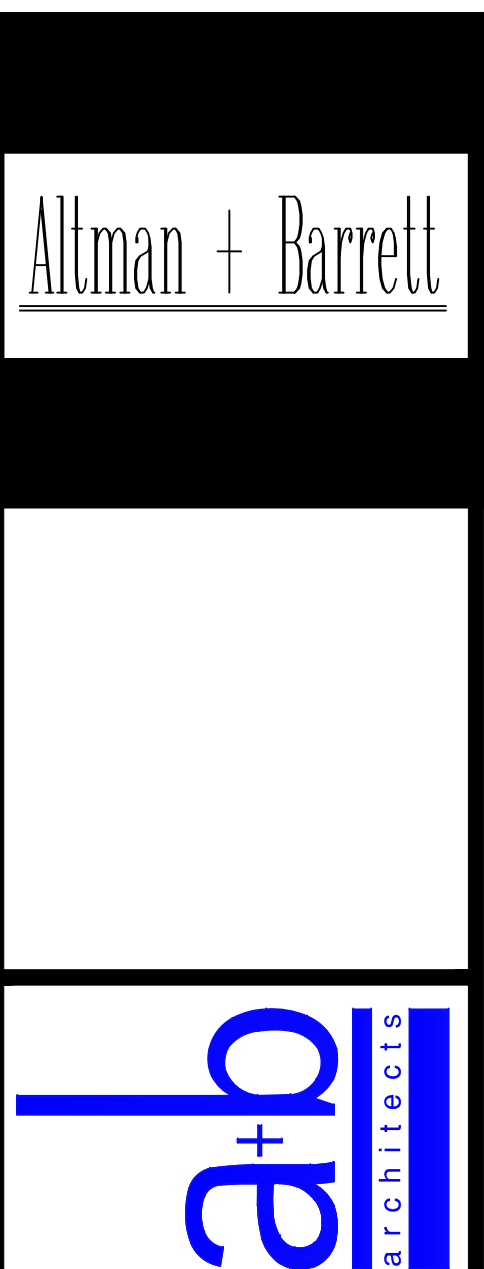

Altman + Barrett
a r c h i t e c t s

Altman + Barrett
a r c h i t e c t s
P.O. BOX 665 - 117 WEST MAIN ST.
HAHIRA, GEORGIA 31632
PHONE # (229) 585-9018

DATE:	August 30, 2021
DRAWN:	M.Roberts, A.Harris
CHECKED:	D. Carter
REVISIONS:	1. 10/4/2021

www.altmanbarrettarchitects.com

Stadium and Field Improvements
West Laurens High School
3692 Highway 257 Dexter, GA 31019
Laurens County School District

C2.1

PROJECT NO: 21013

Drawings are the property of the architect and shall not be reproduced or used without written permission and credit.
© 2021 Altman + Barrett Architects, P.C.

A375-012 Master.dwg